


SUMMARY OF APPROXIMATE QUANTITIES

INDEX BOOK PAGE SHEET	CONTRACT ITEM NO.	CONTRACT ITEM	UNIT	BASE BID		PLAN		AS CONST.		PROJECT TOTALS		DIFF. ±	% PLAN
				PLAN	AS CONST.	PLAN	AS CONST.	PLAN	AS CONST.				
	626-00000	MOBILIZATION	LS	1									
	625-00000	CONSTRUCTION SURVEYING	LS	1									
	203-01596	POTHOLING W/ SURVEYING AND STATIONING OF U/G UTILITES	HR	6									
	210-02004	RELOCATE COMMUNICATION LINES	LF	60									
	207-00210	STOCKPILE TOPSOIL (REMOVE 6")	CY	373									
	207-00205	TOPSOIL	CY	373									
	203-00010	UNCLASSIFIED EXCAVATION (COMPLETE IN PLACE)	CY	615									
	203-00060	EMBANKMENT MATERIAL (COMPLETE IN PLACE)	CY	325									
	304-06000	CLASS 6 BASECOURSE	TN	607									
	403-34721	HOT MIX ASPHALT (PATCHING)	TN	236									
	504-03311	MSE RETAINING WALL W/ GEOGRID	SF	2810									
	206-00100	STRUCTURAL BACKFILL (CLASS 1)	CY	872									
	606-00301	GUARDRAIL TYPE 3 (6-3 SPACING)	LF	169									
	606-02003	END ANCHORAGE (NONFLARED)	EA	2									
	202-01300	REMOVAL OF END ANCHORAGE	EA	2									
	202-01130	REMOVAL OF GUARDRAIL TYPE 3	LF	72									
	606-00301	REPLACE EXISTING GUARDRAIL TYPE 3 (6-3 SPACING)	LF	48									
	514-01030	TIMBER RUBRAIL ON GUARDRAIL	LF	430									
	514-00201	PEDESTRIAN RAILING (STEEL) (SPECIAL)	LF	555									
	614-00011	SIGN PANEL (CLASS 1) (TRAIL SIGN)	EA	7									
	614-00044	TIMBER SIGN POST 4X4 INCH	LF	56									
	210-00810	RESEST GROUND SIGN	EA	3									
	202-05026	SAWCUT ASPHALT MATERIAL	LF	70									
	212-00006	SEEDING (NATIVE)	AC	0.5									
	603-10240	24 INCH CORRUGATED STEEL PIPE	LF	3									
	603-30024	24 INCH STEEL END SECTION	EA	1									
	506-00209	RIPRAP (9 INCH)	CY	2									
	208-00007	EROSION LOG (8 INCH)	LF	838									
	208-00070	STABILIZED CONSTRUCTION ENTRANCE	EA	2									
	210-04010	ADJUST MANHOLE	EA	1									
	607-11525	FENCE (PLASTIC (CONSTRUCTION AND STAGING FENCING)	LF	850									
	412-00815	CONCRETE PAVEMENT (8 INCH) REINFORCED (BOATRAMP)	SY	33									
	514-01020	PEDESTRIAN RAILING (TIMBER) (SPLIT RAIL FENCE)	LF	50									
	614	BOLLARDS	EA	5									
	210	PLACE BOULDERS, 2'X3' AVERAGE	EA	20									
	506-00218	RIPRAP (18 INCH)	CY	16									
	630-00012	TRAFFIC CONTROL MANAGEMENT	DAY	35									
	630-00000	FLAGGING	HR	8									
	630-80341	CONSTRUCTION TRAFFIC SIGN (PANEL SIZE A)	EA	10									
	630-80360	DRUM CHANNELIZING DEVICE	EA	30									
	700-70010	F/A MINOR CONTRACT REVISIONS	FA	1									
	700-70011	F/A PARTNERING	FA	1									
	700-70019	F/A ASPHALT CEMENT COST ADJUSTMENT	FA	1									
	700-70016	F/A FUEL COST ADJUSTMENT	FA	1									


811 FOR BURIED UTILITY INFORMATION
THREE (3) BUSINESS DAYS
BEFORE YOU DIG
CALL 811
(or 1-800-922-1967)
UTILITY NOTIFICATION
CENTER OF COLORADO (UNCC)
www.uncc.org




 Colorado Department of Transportation 222 S. 6th St., Room 100 GRAND JUNCTION, CO., 81501 Phone: 970-248-7230 FAX: 970-248-7294 REGION 3	 ALPINE ENGINEERING INC. EDWARDS BUSINESS CENTER • P.O. BOX 97 EDWARDS, CO. 81632 • FAX 928-3390	Computer File Information Creation Date: 03/01/09 Initials: MCW Last Modification Date: XXXXX Initials: Full Path: P:\ECO08001\DWG\WORK\CDOT\ Drawing File Name: Approx. Quantities.dwg Acad Ver. 2006 Scale: n.t.s Units: English		Sheet Revisions 1 NTP SUBMITTAL 5-7-09 2 CDOT SUBMITTAL 5-27-09 3 MINTURN TRAIL AD SET 7-17-09 4 ADDENDUM #1 8-20-09		As Constructed No Revisions: Revised: Void:		ECO REGIONAL TRAIL DOWD JUNCTION TO MINTURN SUMMARY APPROX. QUANTITIES Designer: MCW Structure Numbers Detailer: MCW Sheet Subset: Subset Sheets:		Project No./Code #ES3006A-043 16945 Sheet Number 5
--	---	--	--	---	--	---	--	---	--	---

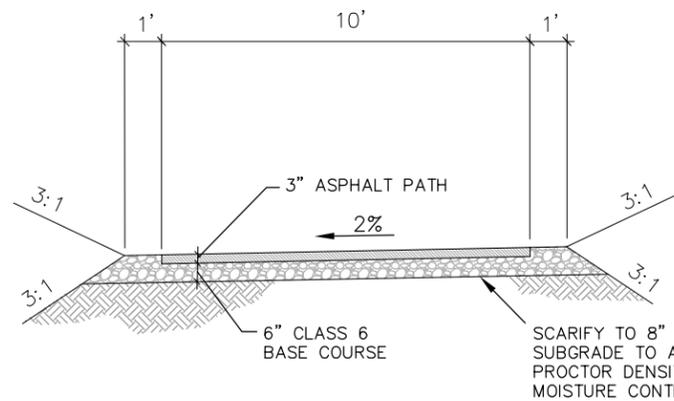


SECTION 0+00 TO 8+05

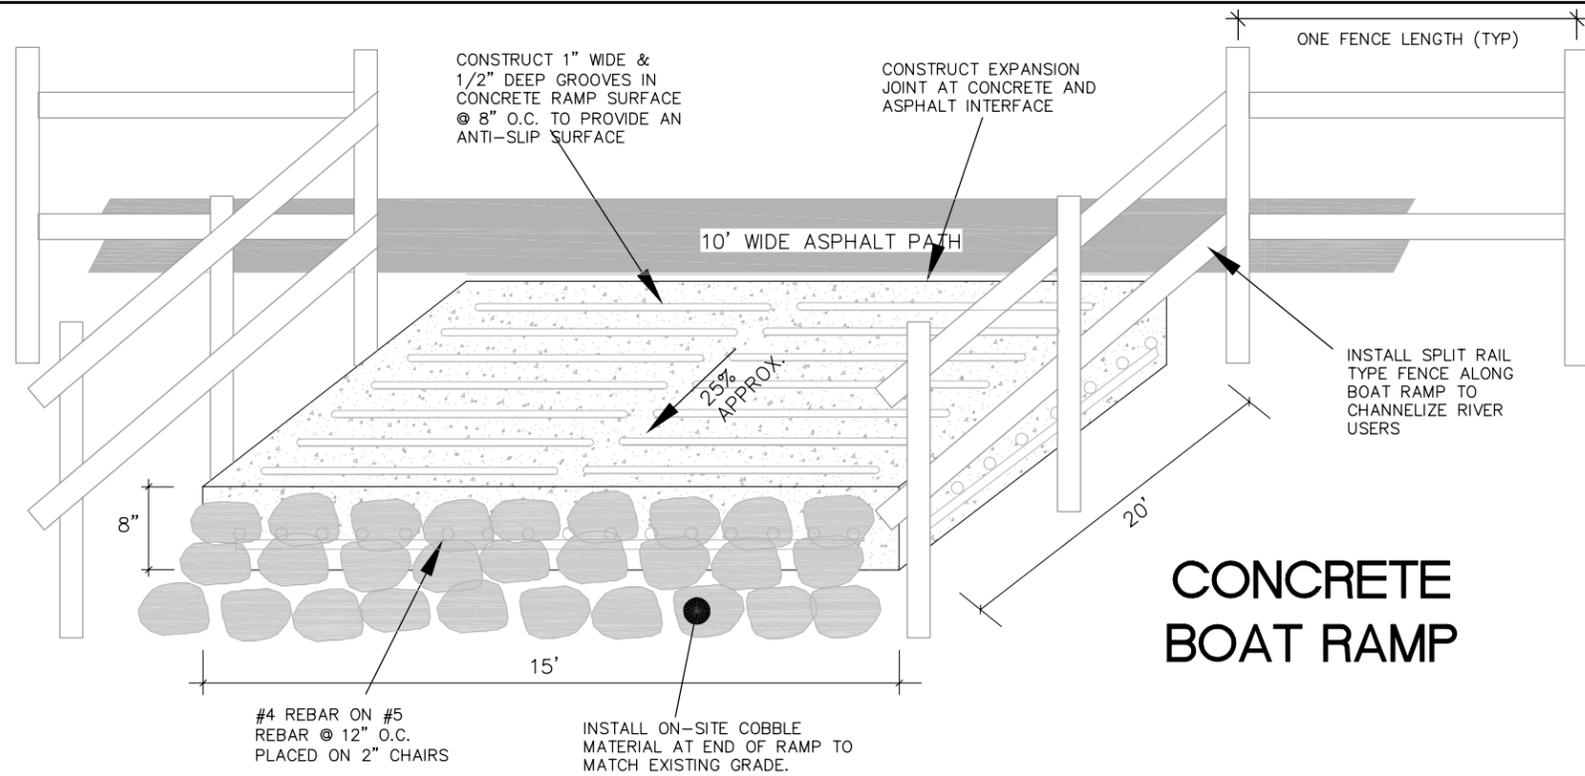


CONCRETE BOAT RAMP

INSTALL 2" X 8" TREATED WOOD "RUB RAIL" ON BACKSIDE OF GUARDRAIL POST. COUNTERSINK HEX NUT AND CUTOFF EXCESS BOLT. ANCHOR RUB RAIL TO GUARDRAIL POSTS. INSTALL RUB RAIL SO THAT BUTT JOINTS ARE AT POST INTERFACES. IN THE EVENT BUTT JOINTS OCCUR ON A SPAN, INSTALL 6"x12" STEEL PLATE CONNECTOR (SEE DETAIL)

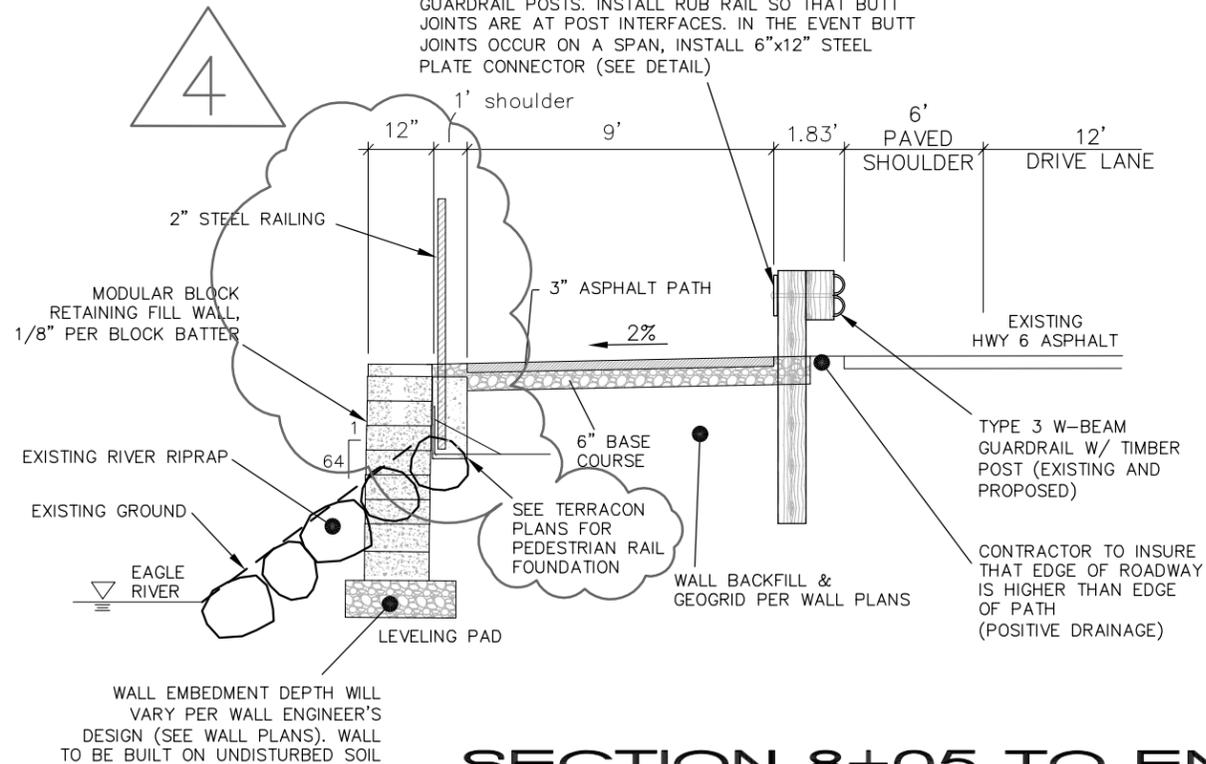


SECTION 8+05 TO END


SCALE: 1" = 5'

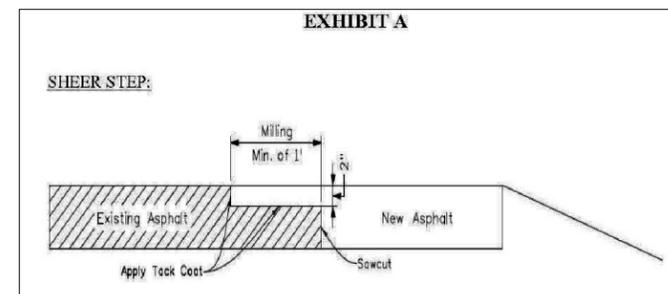

SHEER STEP

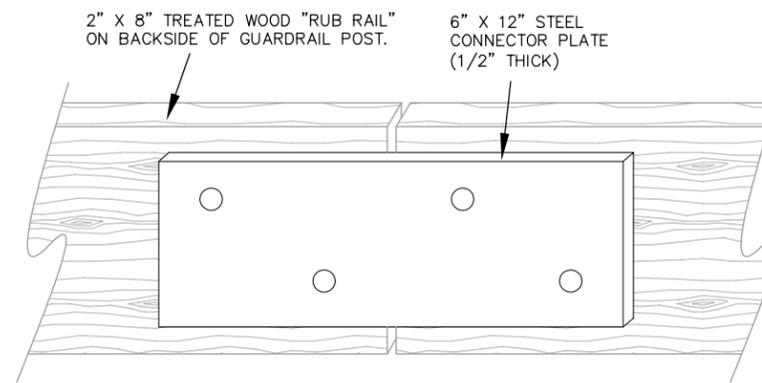


RUB RAIL CONNECTOR PLATE

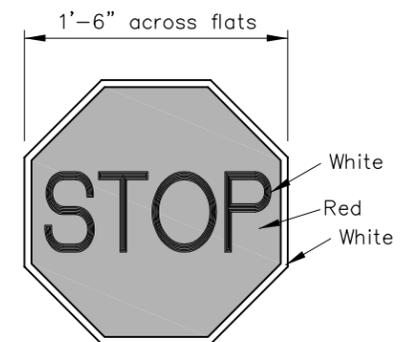

R1-2 STOP
Red and White

PATH- SIGN

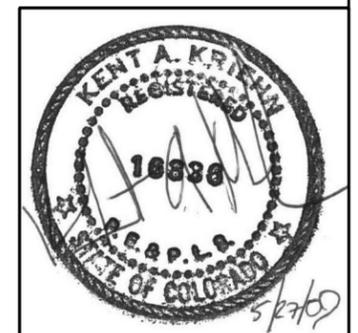

811 FOR BURIED UTILITY INFORMATION
THREE (3) BUSINESS DAYS
BEFORE YOU DIG
CALL 811
(or 1-800-422-1987)
UTILITY NOTIFICATION
CENTER OF COLORADO (UNCC)
www.uncc.org



Colorado Department of Transportation
222 S. 6th St., Room 100
GRAND JUNCTION, CO., 81501
Phone: 970-248-7230
FAX: 970-248-7294



ALPINE
A&E
ENGINEERING INC.
EDWARDS BUSINESS CENTER • P.O. BOX 97
EDWARDS, COLORADO 81632 • FAX 928-3390


Computer File Information	
Creation Date: 03/01/09	Initials: MCW
Last Modification Date: XXXXX	Initials:
Full Path: P:\ECO08001\DWG\WORK\CDOT\	
Drawing File Name: Details.dwg	
Acad Ver. 2006	Scale: n.t.s Units: English

Sheet Revisions		
1	NTP SUBMITTAL	5-7-09
2	CDOT SUBMITTAL	5-27-09
3	MINTURN TRAIL AD SET	7-17-09
4	ADDENDUM #1	8-20-09

As Constructed
No Revisions:
Revised:
Void:



ECO REGIONAL TRAIL DOWD JUNCTION TO MINTURN DETAILS		
Designer: MCW	Structure Numbers	
Detailer: MCW		
Sheet Subset:	Subset Sheets:	

Project No./Code
#ES3006A-043
16945
Sheet Number 14

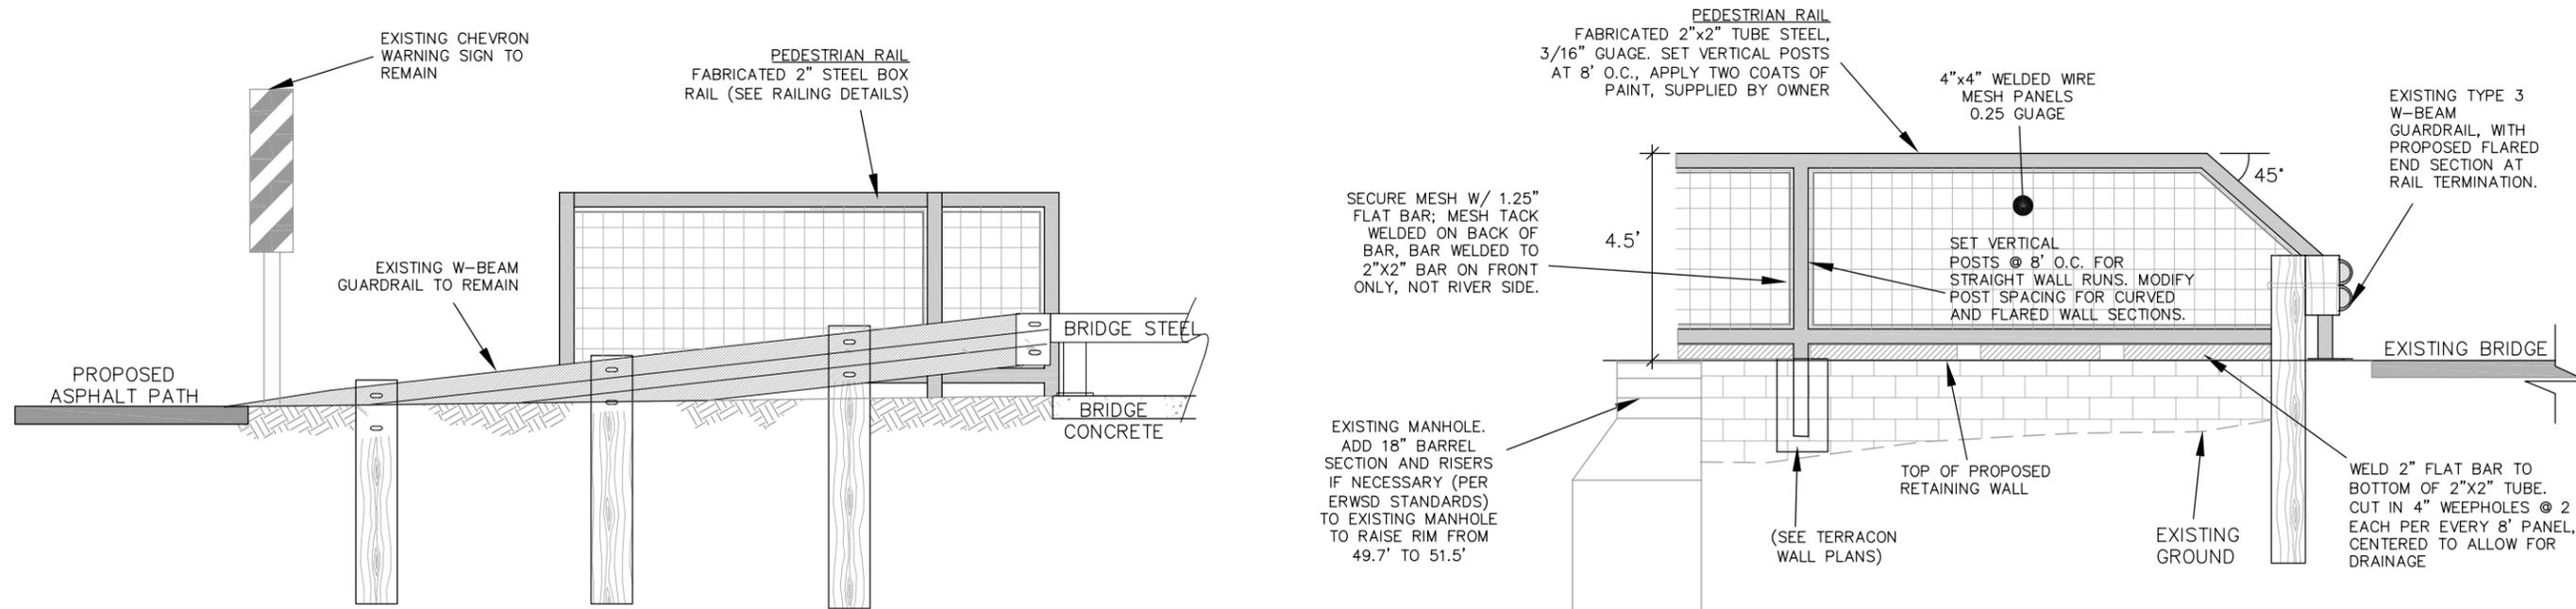

PATH RAIL / GUARDRAIL INTERFACE

SECTION 8+80- EXISTING HWY 6 WITH PATH
SCALE: 1" = 5'

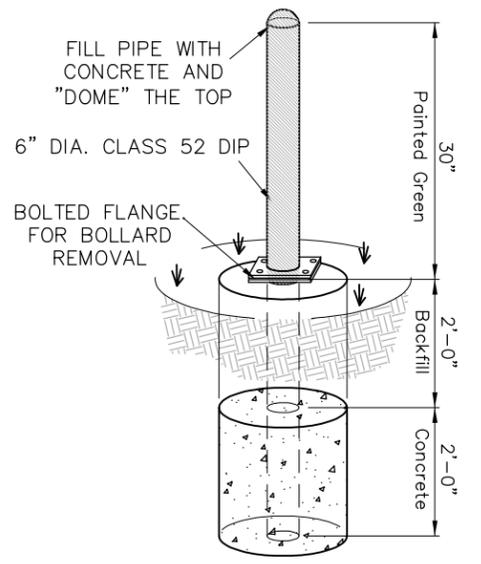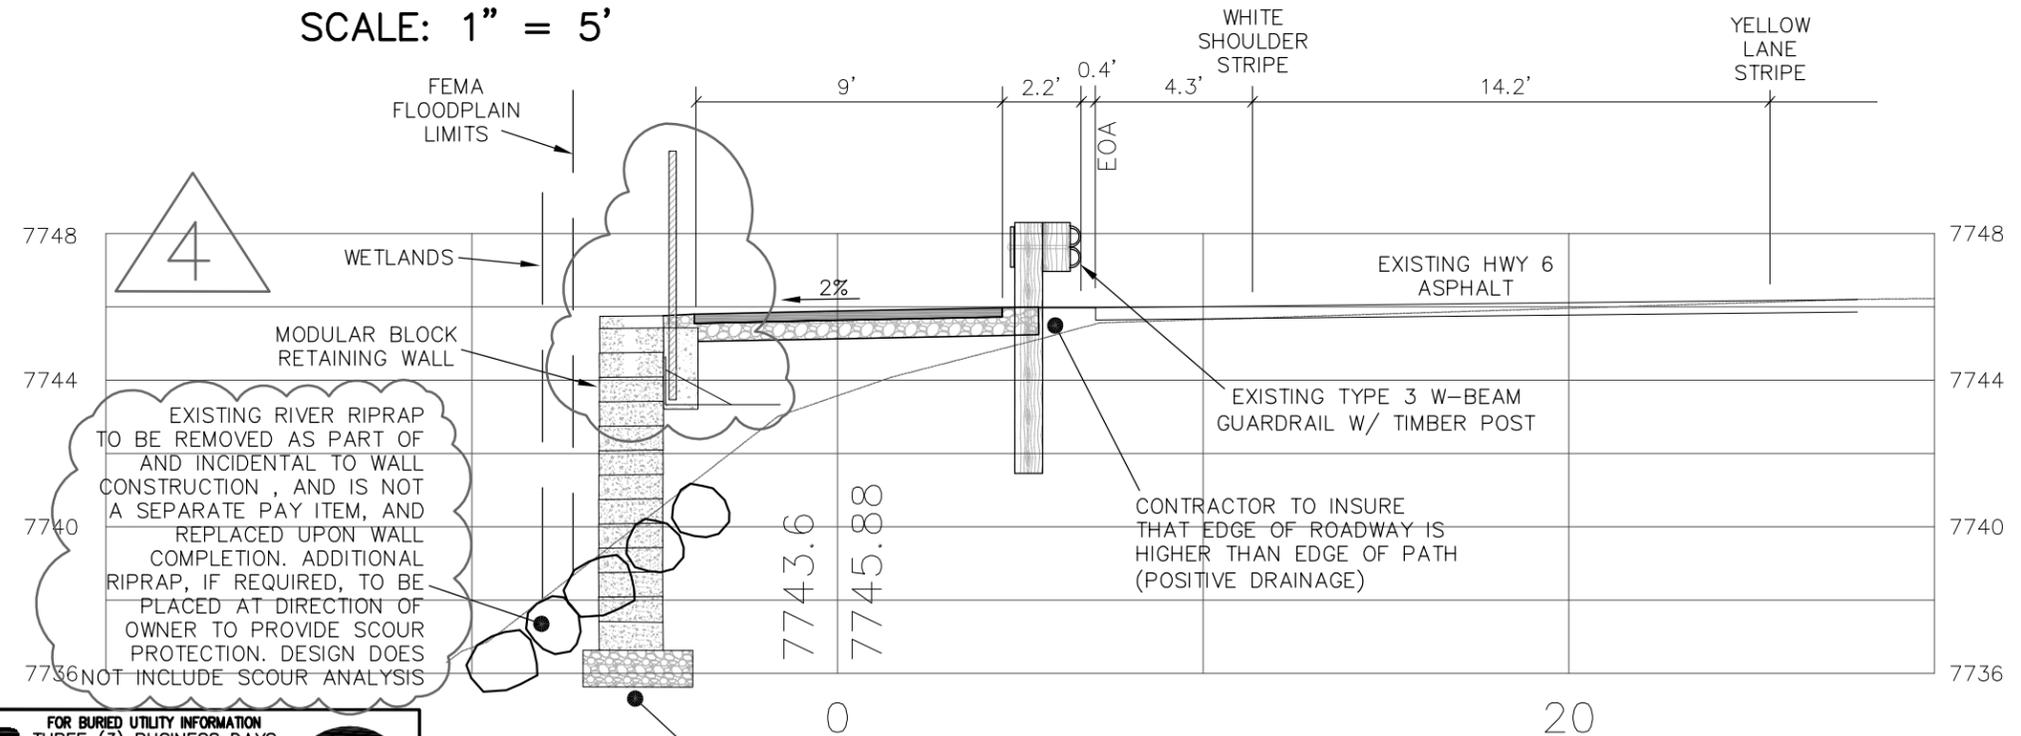

BOLLARD



811 FOR BURIED UTILITY INFORMATION
 THREE (3) BUSINESS DAYS BEFORE YOU DIG
 CALL 811 (or 1-800-922-1987)
 UTILITY NOTIFICATION CENTER OF COLORADO (UNCC)
 www.uncc.org

Colorado Department of Transportation

DOT 222 S. 6th St., Room 100
 GRAND JUNCTION, CO., 81501
 Phone: 970-248-7230
 FAX: 970-248-7294

ALPINE A&E ENGINEERING INC.
 EDWARDS BUSINESS CENTER • P.O. BOX 97
 EDWARDS, COLORADO 81630 • FAX 926-3390

Computer File Information

Creation Date: 03/01/09	Initials: MCW
Last Modification Date: XXXXX	Initials:
Full Path: P:\ECO08001\DWG\WORK\CDOT\	
Drawing File Name: Details.dwg	
Acad Ver. 2006	Scale: n.t.s
	Units: English

Sheet Revisions

1	NTP SUBMITTAL	5-7-09
2	CDOT SUBMITTAL	5-27-09
3	MINTURN TRAIL AD SET	7-17-09
4	ADDENDUM #1	8-20-09

As Constructed

No Revisions:

Revised:

Void:

ECO REGIONAL TRAIL DOWD JUNCTION TO MINTURN DETAILS

Designer: MCW	Structure Numbers:
Detailer: MCW	
Sheet Subset:	Subset Sheets:


Project No./Code

#ES3006A-043

16945

Sheet Number 15

AND DISPOSED OF

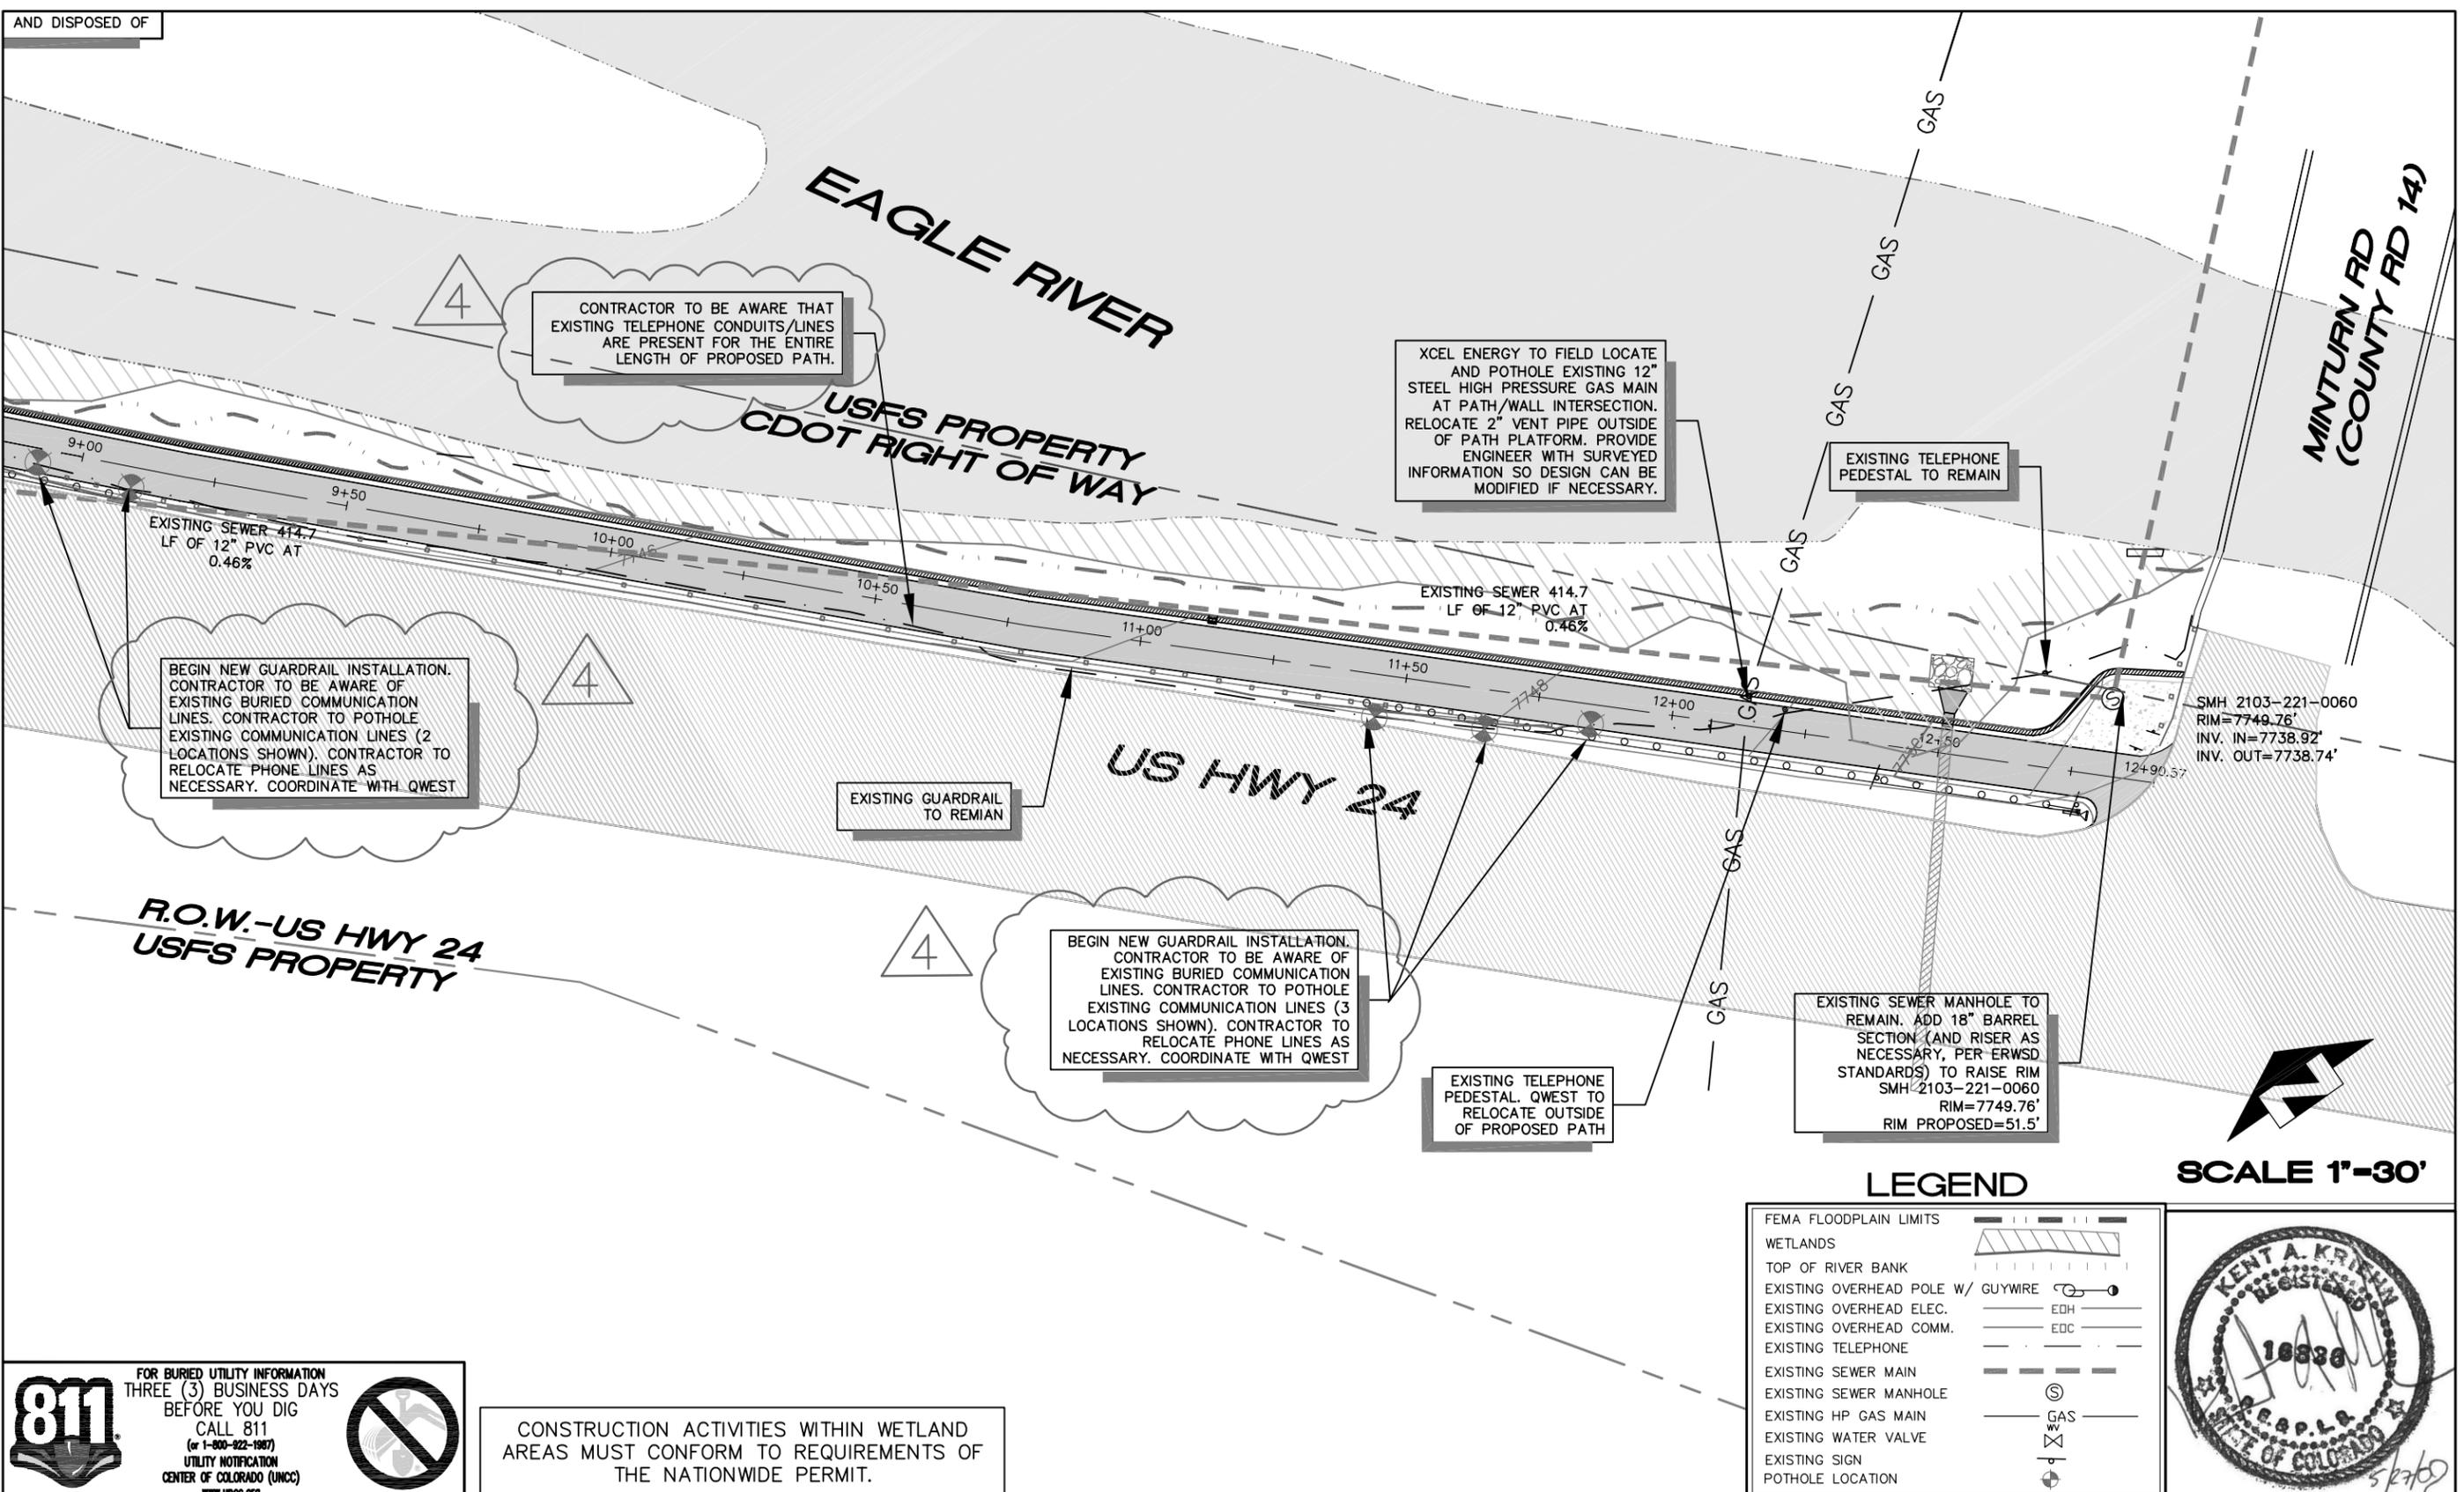

LEGEND

SCALE 1"=30'

FEMA FLOODPLAIN LIMITS	
WETLANDS	
TOP OF RIVER BANK	
EXISTING OVERHEAD POLE W/ GUYWIRE	
EXISTING OVERHEAD ELEC.	
EXISTING OVERHEAD COMM.	
EXISTING TELEPHONE	
EXISTING SEWER MAIN	
EXISTING SEWER MANHOLE	
EXISTING HP GAS MAIN	
EXISTING WATER VALVE	
EXISTING SIGN	
POT-HOLE LOCATION	



811 FOR BURIED UTILITY INFORMATION
THREE (3) BUSINESS DAYS
BEFORE YOU DIG
CALL 811
(or 1-800-422-1987)
UTILITY NOTIFICATION
CENTER OF COLORADO (UNCC)
www.uncc.org

CONSTRUCTION ACTIVITIES WITHIN WETLAND AREAS MUST CONFORM TO REQUIREMENTS OF THE NATIONWIDE PERMIT.

Colorado Department of Transportation

222 S. 6th St., Room 100
GRAND JUNCTION, CO., 81501
Phone: 970-248-7230
FAX: 970-248-7294

ALPINE ENGINEERING INC.
EDWARDS BUSINESS CENTER • P.O. BOX 97
EDWARDS, COLORADO 81632 • FAX 926-3390

REGION 3

Computer File Information	
Creation Date: 03/01/09	Initials: MCW
Last Modification Date: XXXXX	Initials:
Full Path: P:\ECO08001\DWG\WORK\CDOT\	
Drawing File Name: Utility.dwg	
Acad Ver. 2006	Scale: n.t.s Units: English

Sheet Revisions		
1	NTP SUBMITTAL	5-7-09
2	CDOT SUBMITTAL	5-27-09
3	MINTURN TRAIL AD SET	7-17-09
4	ADDENDUM #1	8-20-09

As Constructed

No Revisions:

Revised:

Void:

**ECO REGIONAL TRAIL
DOWD JUNCTION TO MINTURN
UTILITY PLAN**

Designer: MCW
Detailer: MCW

Structure Numbers
Subset Sheets:

Project No./Code
#ES3006A-043

16945

Sheet Number 21